




PROPOSED SIGNS

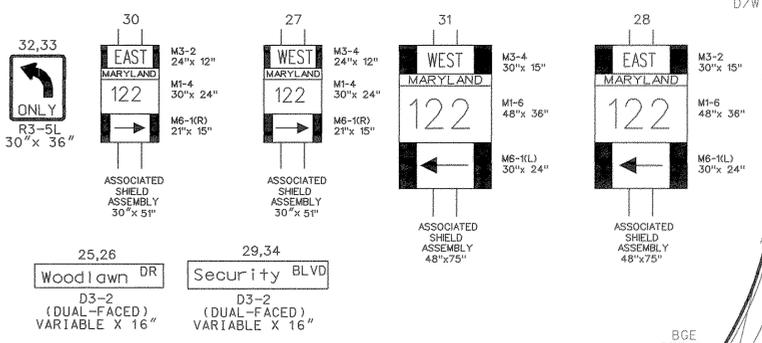

PROPOSED SIGNAL HEADS

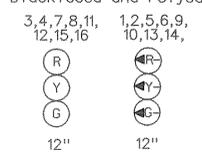


NEMA PHASING

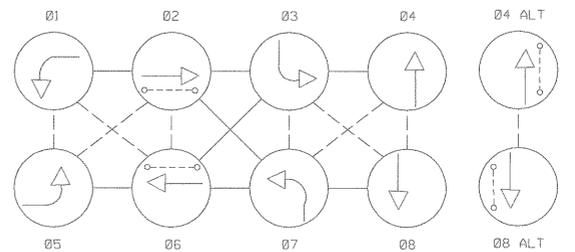

EXISTING SIGNAL HEADS



MD 122 IS ASSUMED TO RUN IN AN EAST-WEST DIRECTION

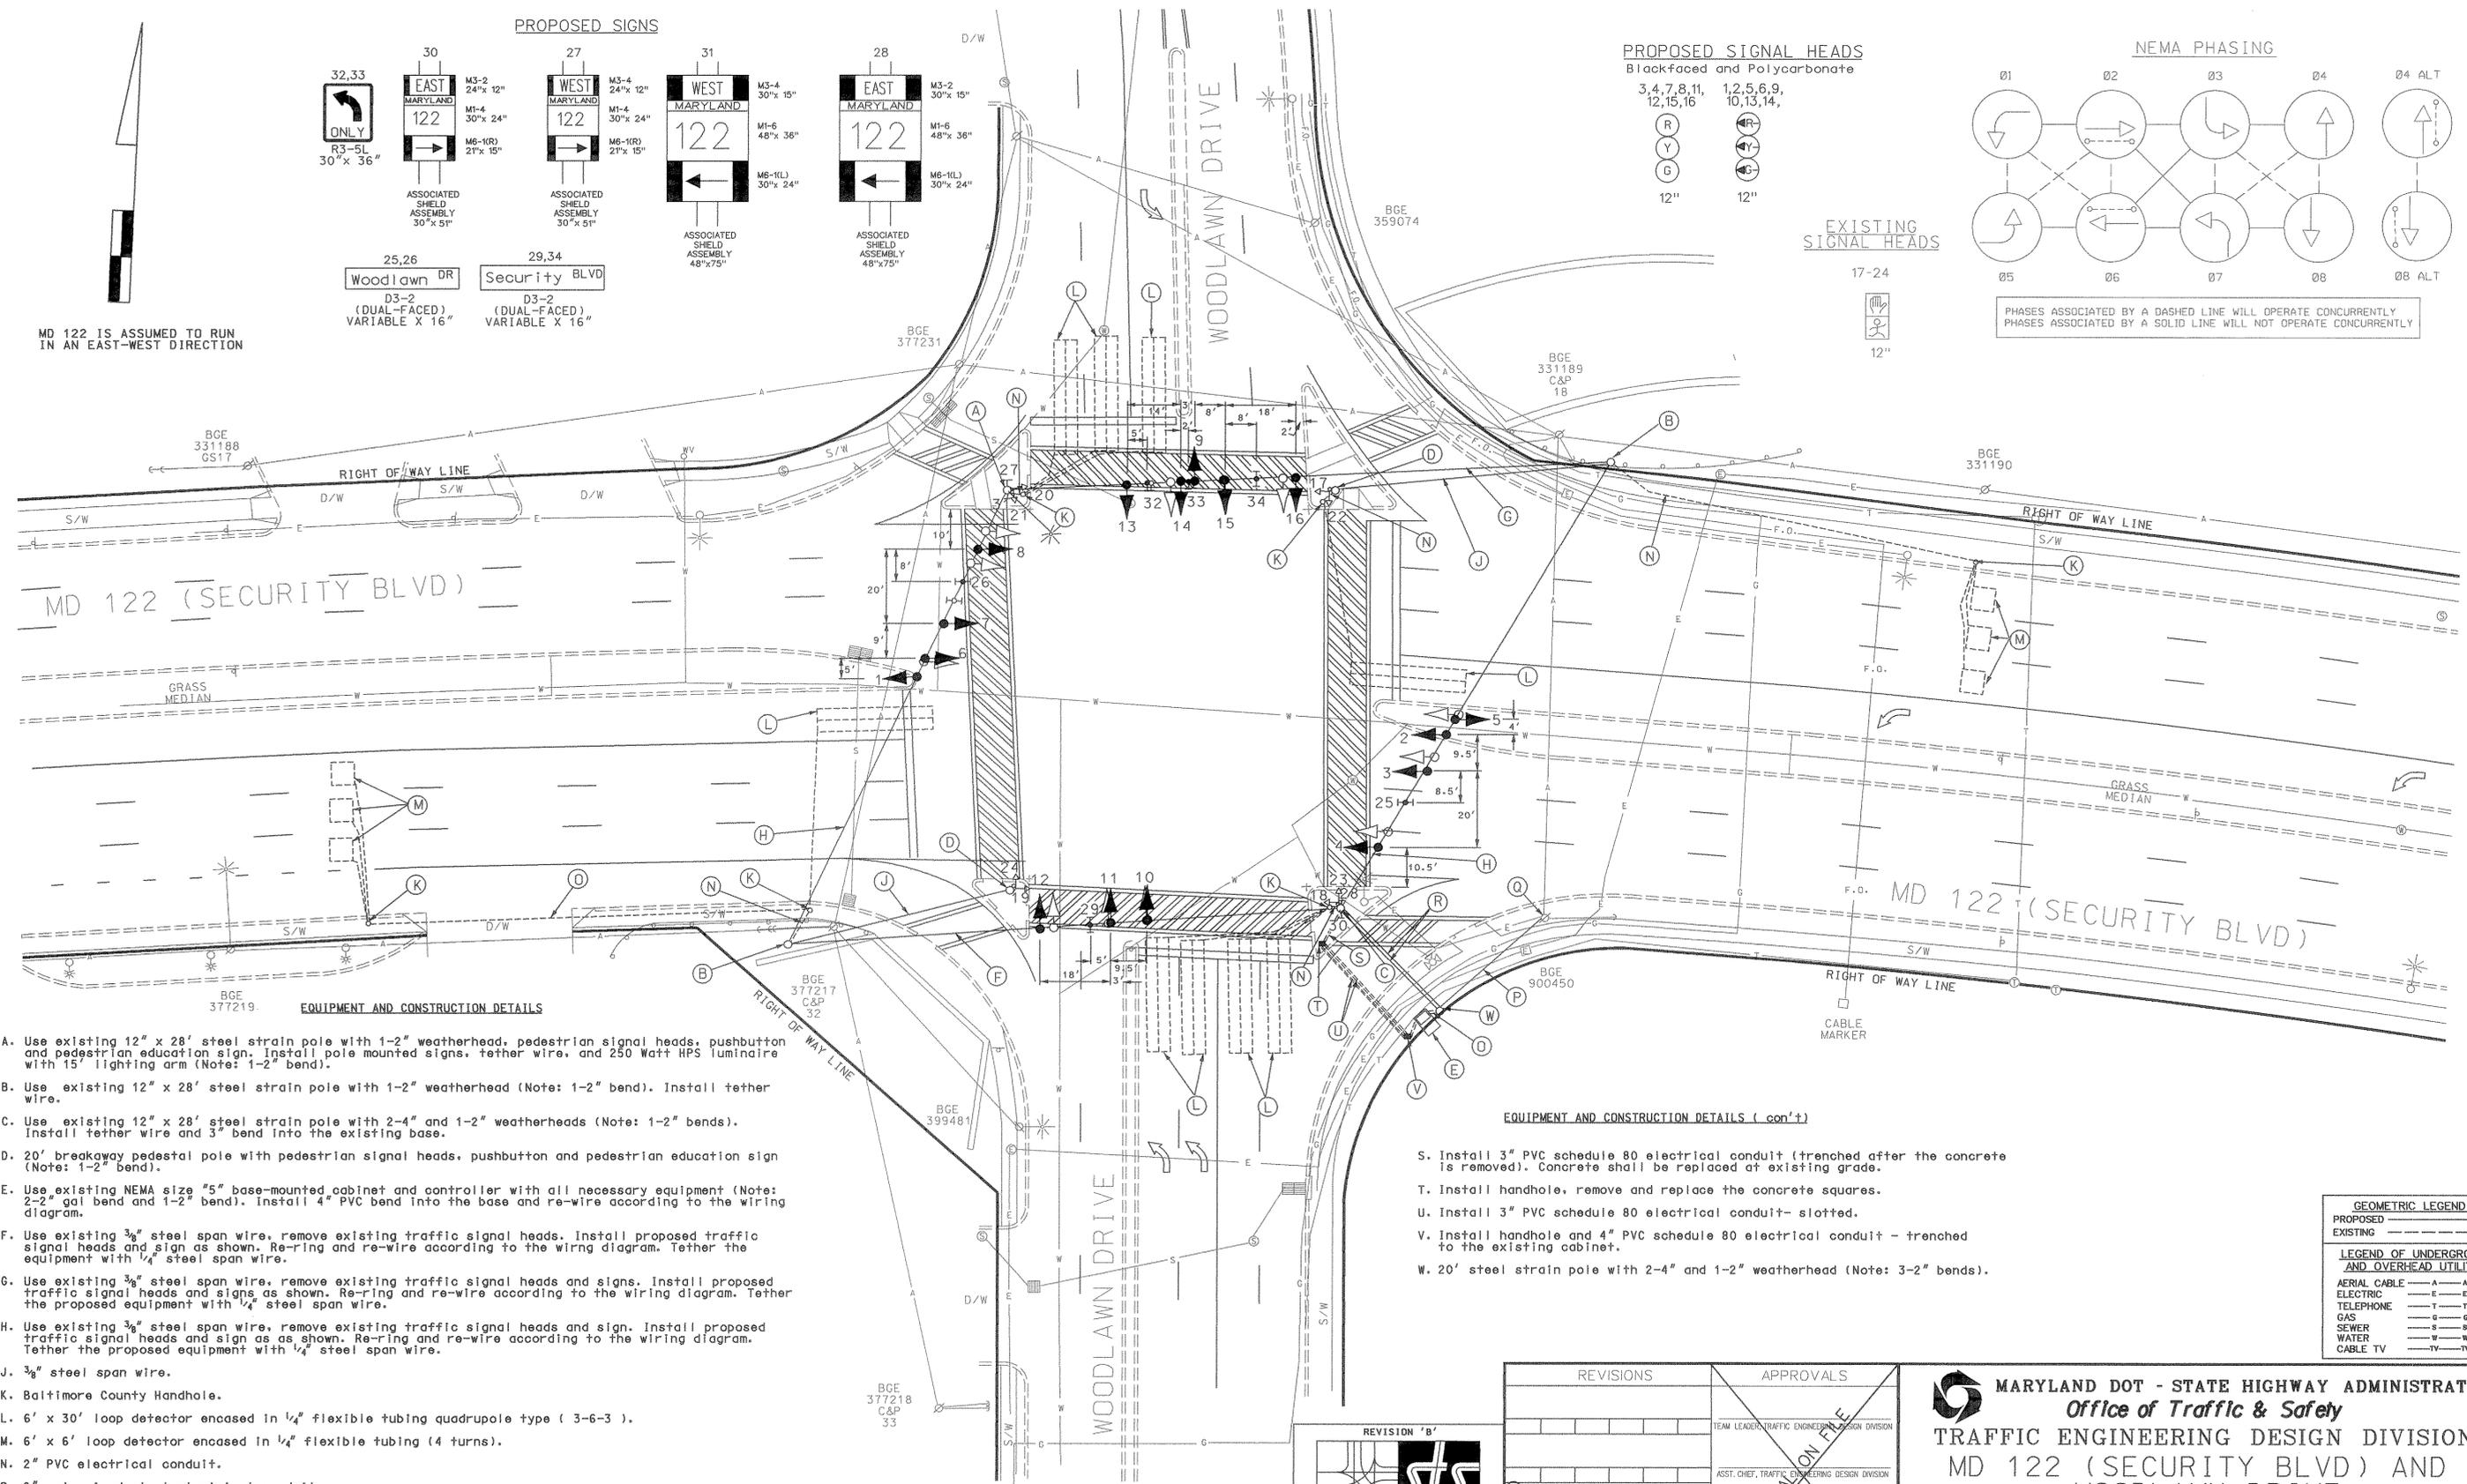

EQUIPMENT AND CONSTRUCTION DETAILS

- A. Use existing 12" x 28" steel strain pole with 1-2" weatherhead, pedestrian signal heads, pushbutton and pedestrian education sign. Install pole mounted signs, tether wire, and 250 Watt HPS luminaire with 15' lighting arm (Note: 1-2" bend).
- B. Use existing 12" x 28" steel strain pole with 1-2" weatherhead (Note: 1-2" bend). Install tether wire.
- C. Use existing 12" x 28" steel strain pole with 2-4" and 1-2" weatherheads (Note: 1-2" bends). Install tether wire and 3" bend into the existing base.
- D. 20' breakaway pedestal pole with pedestrian signal heads, pushbutton and pedestrian education sign (Note: 1-2" bend).
- E. Use existing NEMA size "5" base-mounted cabinet and controller with all necessary equipment (Note: 2-2" gal bend and 1-2" bend). Install 4" PVC bend into the base and re-wire according to the wiring diagram.
- F. Use existing 3/8" steel span wire, remove existing traffic signal heads. Install proposed traffic signal heads and sign as shown. Re-ring and re-wire according to the wiring diagram. Tether the equipment with 1/4" steel span wire.
- G. Use existing 3/8" steel span wire, remove existing traffic signal heads and signs. Install proposed traffic signal heads and sign as shown. Re-ring and re-wire according to the wiring diagram. Tether the proposed equipment with 1/4" steel span wire.
- H. Use existing 3/8" steel span wire, remove existing traffic signal heads and sign. Install proposed traffic signal heads and sign as shown. Re-ring and re-wire according to the wiring diagram. Tether the proposed equipment with 1/4" steel span wire.
- J. 3/8" steel span wire.
- K. Baltimore County Handhole.
- L. 6' x 30' loop detector encased in 1/4" flexible tubing quadrupole type (3-6-3).
- M. 6' x 6' loop detector encased in 1/4" flexible tubing (4 turns).
- N. 2" PVC electrical conduit.
- O. 2" galvanized steel electrical conduit.
- P. Existing overhead service by BGE.
- Q. Existing BGE service pole with control and distribution equipment.
- R. Install 3/8" steel span wire along existing span and re-ring.

EQUIPMENT AND CONSTRUCTION DETAILS (cont.)

- S. Install 3" PVC schedule 80 electrical conduit (trenched after the concrete is removed). Concrete shall be replaced at existing grade.
- T. Install handhole, remove and replace the concrete squares.
- U. Install 3" PVC schedule 80 electrical conduit - slotted.
- V. Install handhole and 4" PVC schedule 80 electrical conduit - trenched to the existing cabinet.
- W. 20' steel strain pole with 2-4" and 1-2" weatherhead (Note: 3-2" bends).

GEOMETRIC LEGEND

PROPOSED ————
EXISTING - - - - -

LEGEND OF UNDERGROUND AND OVERHEAD UTILITIES

AERIAL CABLE — A — A
ELECTRIC — E — E
TELEPHONE — T — T
GAS — G — G
SEWER — S — S
WATER — W — W
CABLE TV — TV — TV

REVISION 'B'

STREET TRAFFIC STUDIES, LTD.
400 Crain Hwy., N.W.
Glen Burnie, MD 21061
Ph (410) 590-5500
Fax (410) 590-6637

3964.DGN TASK 10

REVISIONS	APPROVALS
B 5-17-01 ASBUILT AND REPLACE EXISTING SIGNAL HEADS SHA NO: XX-1005485	TEAM LEADER, TRAFFIC ENGINEERING DESIGN DIVISION
A 2-24-88 ADD DUAL W/B LEFTS AND PED SIGNALS	ASST. CHIEF, TRAFFIC ENGINEERING DESIGN DIVISION
	CHIEF, TRAFFIC ENGINEERING DESIGN DIVISION
	DIRECTOR, TRAFFIC & SAFETY

MARYLAND DOT - STATE HIGHWAY ADMINISTRATION
Office of Traffic & Safety
TRAFFIC ENGINEERING DESIGN DIVISION
MD 122 (SECURITY BLVD) AND WOODLAWN DRIVE

DRAWN BY: Balto. County	F.A.P. NO. 0928 ASH/054	TS NO. 4089B	SHEET NO. 1 OF 2
CHECKED BY: [Signature]	S.H.A. NO. [Blank]	T.I.M.S. NO. E 583	
SCALE: 1" = 20'	COUNTY: BALTIMORE		
DATE: 2/24/88	LOG MILE: 03012201.09		